

# ELEVATION CERTIFICATE

## FEDERAL EMERGENCY MANAGEMENT AGENCY NATIONAL FLOOD INSURANCE PROGRAM

O.M.B. No 3067-00  
Expires May 31, 12

**ATTENTION:** Use of this certificate does not provide a waiver of the flood insurance purchase requirement. This form is used only to provide elevation information necessary to ensure compliance with applicable community floodplain management ordinances, to determine the proper insurance premium rate, and/or to support a request for a Letter of Map Amendment or Revision (LOMA or LOMR). Instructions for completing this form can be found on the following pages.

SECTION A PROPERTY INFORMATION		FOR INSURANCE COMPANY USE
BUILDING OWNER'S NAME <u>H. P. Honeycutt</u>	POLICY NUMBER	
STREET ADDRESS (Including Apt., Unit, Suite and/or Bldg. Number) OR P.O. ROUTE AND BOX NUMBER <u>2005 American Legion</u>	COMPANY NAIC NUMBER	
OTHER DESCRIPTION (Lot and Block Numbers, etc.) <u>LOT 17 &amp; 18 B/LK 3 WESTERN HOMES Subdivision</u>		
CITY <u>Mountain Home</u>	STATE <u>Idaho</u>	ZIP CODE <u>83647</u>

### SECTION B FLOOD INSURANCE RATE MAP (FIRM) INFORMATION

Provide the following from the proper FIRM (See Instructions):

1. COMMUNITY NUMBER	2. PANEL NUMBER	3. SUFFIX	4. DATE OF FIRM INDEX	5. FIRM ZONE	6. BASE FLOOD ELEVATION (in AO Zones, use depth)
<u>16005B</u>	<u>0005C</u>	<u>C</u>	<u>3-15-94</u>	<u>AE ZONE</u>	<u>3141 AE ZONE</u>

7. Indicate the elevation datum system used on the FIRM for Base Flood Elevations (BFE):  NGVD '29  Other (describe on back)
8. For Zones A or V, where no BFE is provided on the FIRM, and the community has established a BFE for this building site, indicate the community's BFE: 3141.6 feet NGVD (or other FIRM datum—see Section B, Item 7).

### SECTION C BUILDING ELEVATION INFORMATION

1. Using the Elevation Certificate Instructions, indicate the diagram number from the diagrams found on Pages 5 and 6 that best describes the subject building's reference level: 2
- 2(a) FIRM Zones A1-A30, AE, AH, and A (with BFE). The top of the reference level floor from the selected diagram is at an elevation of 3142.6 feet NGVD (or other FIRM datum—see Section B, Item 7).
- (b) FIRM Zones V1-V30, VE, and V (with BFE). The bottom of the lowest horizontal structural member of the reference level from the selected diagram, is at an elevation of        feet NGVD (or other FIRM datum—see Section B, Item 7).
- (c) FIRM Zone A (without BFE). The floor used as the reference level from the selected diagram is        feet above  or below  (check one) the highest grade adjacent to the building.
- (d) FIRM Zone AO. The floor used as the reference level from the selected diagram is        feet above  or below  (check one) the highest grade adjacent to the building. If no flood depth number is available, is the building's lowest floor (reference level) elevated in accordance with the community's floodplain management ordinance?  Yes  No  Unknown
3. Indicate the elevation datum system used in determining the above reference level elevations:  NGVD '29  Other (describe under Comments on Page 2). (NOTE: If the elevation datum used in measuring the elevations is different than that used on the FIRM [see Section B, Item 7], then convert the elevations to the datum system used on the FIRM and show the conversion equation under Comments on Page 2.)
4. Elevation reference mark used appears on FIRM:  Yes  No (See Instructions on Page 4)
5. The reference level elevation is based on:  actual construction  construction drawings  
(NOTE: Use of construction drawings is only valid if the building does not yet have the reference level floor in place, in which case this certificate will only be valid for the building during the course of construction. A post-construction Elevation Certificate will be required once construction is complete.)
8. The elevation of the lowest grade immediately adjacent to the building is: 3142.6 feet NGVD (or other FIRM datum—see Section B, Item 7).

### SECTION D COMMUNITY INFORMATION

1. If the community official responsible for verifying building elevations specifies that the reference level indicated in Section C, Item 1 is not the "lowest floor" as defined in the community's floodplain management ordinance, the elevation of the building's "lowest floor" as defined by the ordinance is:        feet NGVD (or other FIRM datum—see Section B, Item 7).
2. Date of the start of construction or substantial improvement: 2-5-95 Rch

**SECTION E CERTIFICATION**

This certification is to be signed by a land surveyor, engineer, or architect who is authorized by state or local law to certify elevation information when the elevation information for Zones A1-A30, AE, AH, A (with BFE), V1-V30, VE, and V (with BFE) is required. Community officials who are authorized by local law or ordinance to provide floodplain management information, may also sign the certification. In the case of Zones AO and A (without a FEMA or community issued BFE), a building official, a property owner, or an owner's representative may also sign the certification.


Reference level diagrams 6, 7 and 8 - Distinguishing Features-If the certifier is unable to certify to breakaway/non-breakaway wall, enclosure size, location of servicing equipment, area use, wall openings, or unfinished area Feature(s), then list the Feature(s) not included in the certification under Comments below. The diagram number, Section C, Item 1, must still be entered.

I certify that the information in Sections B and C on this certificate represents my best efforts to interpret the data available. I understand that any false statement may be punishable by fine or imprisonment under 18 U.S. Code, Section 1001.

James J. Howard LS/PE Idaho 2471  
 CERTIFIER'S NAME LICENSE NUMBER (or Affix Seal)  
OWNER J.J. Howard Engineering  
 TITLE COMPANY NAME  
2626 N. 32nd St BOISE Idaho 83703  
 ADDRESS CITY STATE ZIP  
James J Howard 5-5-95 1-208 344-0574  
 SIGNATURE DATE PHONE

Copies should be made of this Certificate for: 1) community official, 2) insurance agent/company, and 3) building owner.

COMMENTS: This STRUCTURE FALLS WITHIN THE  
Floodway, HOWEVER, it HAS BEEN  
constructed on land that is ABOVE  
THE BASE FLOOD ELEVATION (BFE)  
and is therefore EXEMPT  
JJ Howard

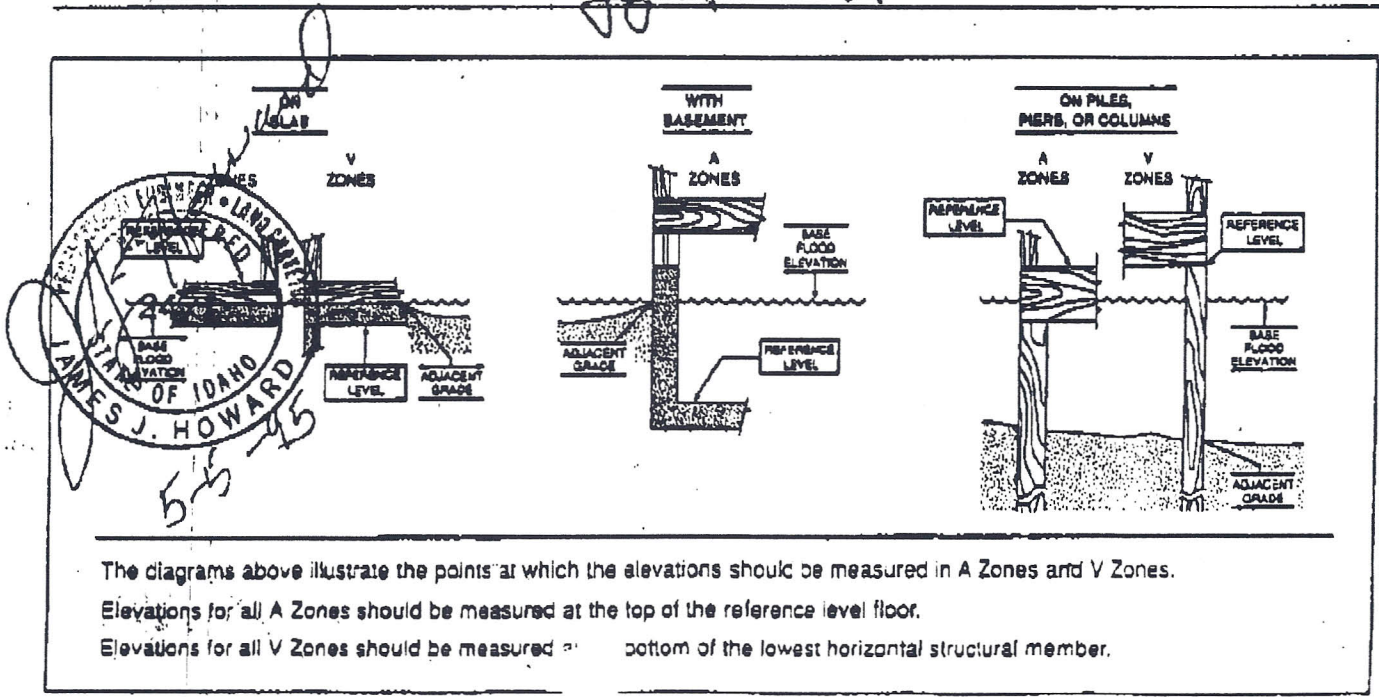


The diagrams above illustrate the points at which the elevations should be measured in A Zones and V Zones. Elevations for all A Zones should be measured at the top of the reference level floor. Elevations for all V Zones should be measured at the bottom of the lowest horizontal structural member.

**J. J. HOWARD  
ENGINEERING & SURVEYING**

2626 N. 32nd Street  
BOISE, IDAHO 83703  
(208) 344-0574

JOB HP. Honecutt  
SHEET NO. Flood Way OF \_\_\_\_\_  
CALCULATED BY ELEVATION DATE 11-29-94  
CHECKED BY \_\_\_\_\_ DATE \_\_\_\_\_  
SCALE Lyon/Howard

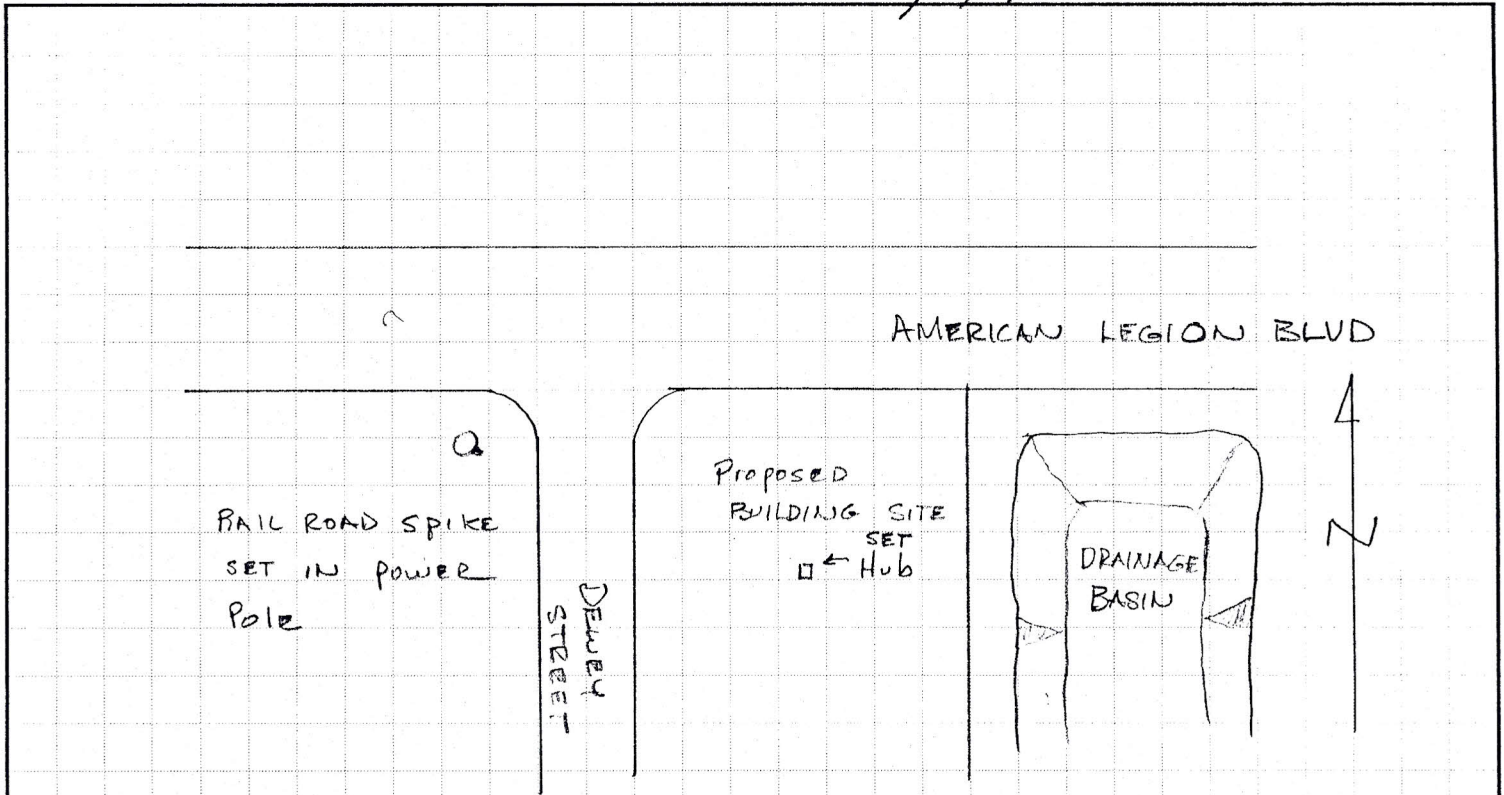

POINT	BS +	HI	FS. -	ELEV	NOTES
BC @ Am Lg. Blvd	6.08	46.16		3140.08	B.CAP @ AL. BLVD 3140.08* AND 18th EAST
TP #1	5.99		4.97	41.19	
		3147.18			
Hub ON SITE			3.47	3143.71	
RAIL ROAD SPIKE IN POWER POLE			3.53	3143.65	
* ELEV ROW in from BC. @ Bridge by douglas TREE					

DATE January 19, 1995

*Red Barn*

Floodplain Permit No. 1-95

# Development Permit Application

APPLICANT Red Barn Supply/H.P.Honeycutt ADDRESS 2005 Am. Lgn. Blvd.

Phone: 587- ADDRESS OF CONSTRUCTION 2005 Am. Lgn. Blvd.

### DESCRIPTION OF PROPOSED WORKS:

- |                                                     |                                                |
|-----------------------------------------------------|------------------------------------------------|
| <input checked="" type="checkbox"/> NEW BUILDING    | <input type="checkbox"/> MOBILE HOME PLACEMENT |
| <input type="checkbox"/> Residential                | <input type="checkbox"/> On Single Lot         |
| <input checked="" type="checkbox"/> Non/Residential | <input type="checkbox"/> In Mobile Home Park   |
| <input type="checkbox"/> ADDITION/ALTERATION        | <input type="checkbox"/> Replacement           |
| <input type="checkbox"/> SUBDIVISION OF LAND        | <input type="checkbox"/> New Placement         |
| <input type="checkbox"/> FILL                       |                                                |
| <input type="checkbox"/> WATERCOURSE ALTERATION     | <input type="checkbox"/> OTHER                 |

Market Value of Exist. Property \$ N/A  
Estimated Cost of Proposed Construction \$ 156,300.00

If this is an Addition/Alteration, is the improvement 50% or more of the market value of the already existing Building?  Yes  No  N/A

Attach the following information where applicable: Plans of the development to be undertaken including any filling and any watercourse or drainage way alteration.

Specifically, the following information is required; (1) Mean sea level (MSL) elevation of the lowest floor (including basement) of all proposed structures; (2) MSL elevation to which a proposed structure will be floodproofed; (3) certification by a registered professional engineer or architect that the floodproofing method meets the community floodproofing criteria; (4) a description of the extent to which any watercourse will be altered or relocated, and (5) base (100-year) flood elevation data for a development or subdivision greater than 50 lots or 5 acres.

### THE FOLLOWING IS TO BE COMPLETED BY THE LOCAL ADMINISTRATOR

Proposed development is located in                      Flood Hzd. Area  Building height exceeds floodway elev.  Floodway  
Base Flood Elev. of Site is: 3141 Source: FIRM Map Eff. Date: 03/30/88 March 15, 1994

### PLAN REVIEW

MSL Elevation/Depth Number structure is to be elevated/floodproofed 3141 feet.  
Are necessary information, certificates and other permits attached?  Yes  No

### ACTION TAKEN

- The proposed development is in conformance with applicable floodplain standards. PERMIT IS APPROVED
- The proposed development is not in conformance with applicable floodplain standards (explanation attached). PERMIT IS DENIED
- The proposed addition/alteration is not 50% or more of the market value of the existing building. NO FLOOD PERMIT REQUIRED

Date: 1/19/95 Local Administrator: *Paul D. Raymond*  
Paul D. Raymond, City Engineer

City Bldg. Permit No. 5020